

Richard B. Ingraham
RBI Computers and Audio

Chuck Meacham
University of Evansville Tech


University of Evansville Shanklin Theater

Sound System

Lipp AV Design, Inc.

Jeffrey Lipp Principal Consultant

Phone: (847) 808-8:
It Fax: (847) 808-8791
E-Mall: jeff@lippav.com
420 Mayfair Lane
Buffalo Grove, IL 60089
www.lippav.com

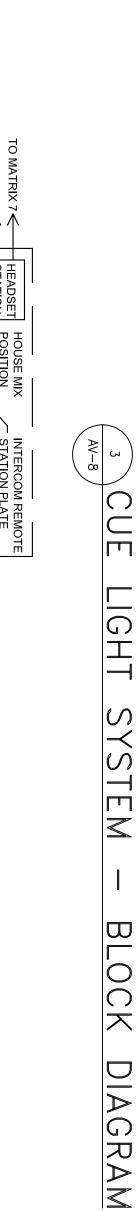

RJ45 PATCH BAY IN AMP RACK

1-2-21

ф

<u>N</u>2

R. VOM PLATE


Ş

Ş

N2

BOOTH N4

RECORD BOOTH
WALL PLATE
N2

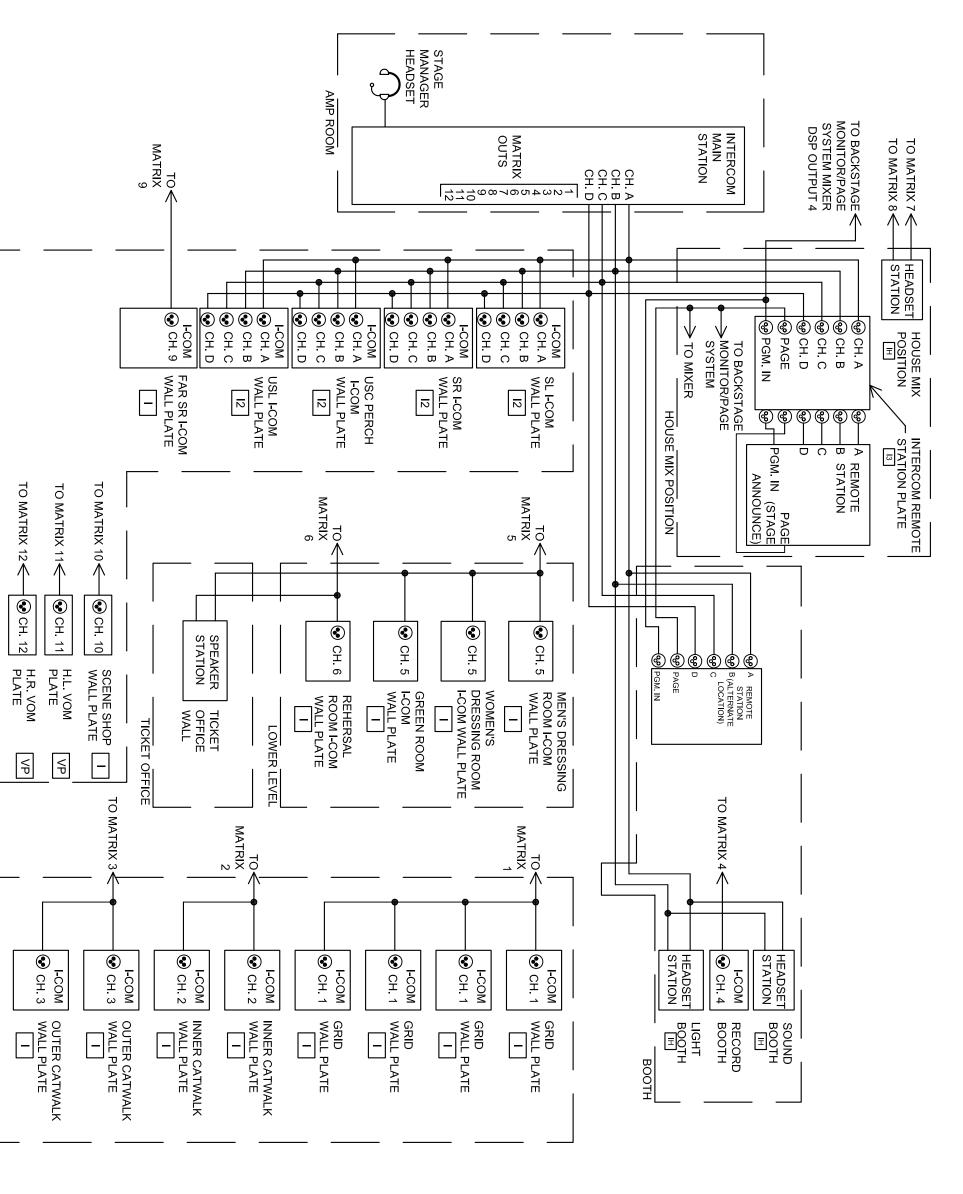

AT5

NETWORK)

5

 \leq

BLOC

 $|\mathbf{x}|$

DIAGRAM

HOUSE MIX POSITION (IN-LINE CONNECTORS)

RECORD BOOTH
WALL PLATE

TIE Sant

(IN-LINE CONNECTIONS)

LINES

TIE

Ż E

YS:

.0CK

DIAGRAM

INTERCOM SYSTEM BLOCK DIAGRAM

BLOC	Drawn By: NCV	PROJECT PHASE	COMMISSION NO.	Mark Date	11.10.07	6.13.07	6.01.07	5.14.07
BLOCK DIAGRAMS	Checked By: JDL			Description	AS-BUILT	REV.2	REV.I	AV DESIGN CONCEPT

A-\ 8--8